


## As Shown in Schematic



## As Built (Corrected)

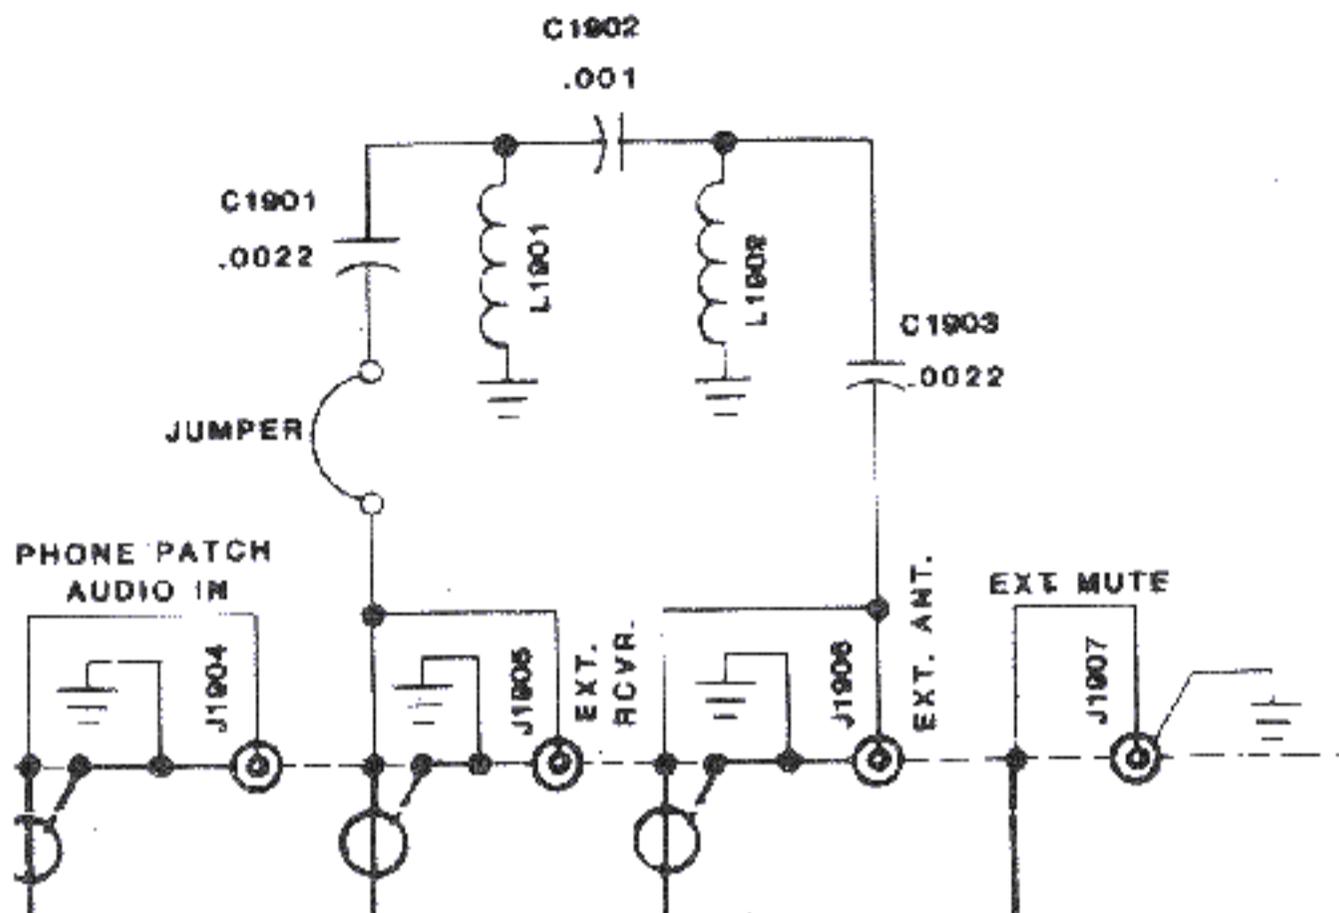